




FOR EXTRA DETAIL SEE INSET A

Maintenance Bay

SCALE: 1:500

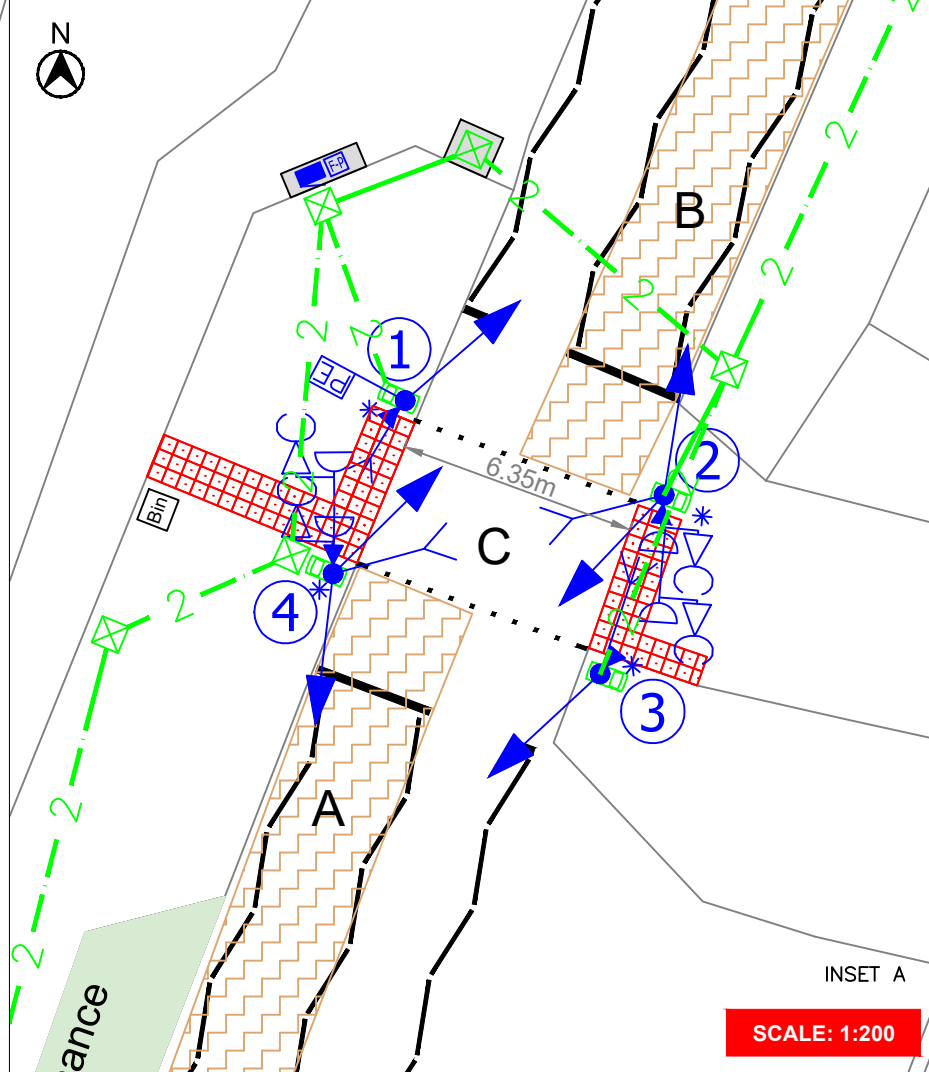

INSET A

SCALE: 1:200

KEY

- Controller case.
- Feeder pillar.
- Primary RAG Signal
- Integrated near sided toucan unit and push button w/ repeater nearsided Toucan Display
- Push Button
- MVD
- On Crossing Detector
- Kerbside Detector
- ELV photoelectric cell (solar cell)

SIGNAL HEAD TYPE	
POLE NUMBER	① ② x2 ② ③ ④ x2 ④ ① ② ③ ④



BATH & NORTH EAST SOMERSET

Floor 2 South, Riverside Temple Street, Keynsham,
Bristol BS31 1LA.
Telephone: (01225) 395253
Fax: (01225) 394338

PRODUCED BY

Highway Electrical and
Intelligent Transport Systems
10.249.151.62

SCHEME TITLE

Silver St/ Lynwood Toucan
As Built Drawing

DRAWING TITLE

SCN 5062

POSTCODE : BA3 2WD

DATE Jan 26

DRAWN BY JMD

APPROVED BY PT

SCALE As Shown@A3

CHECKED PT

CLIENT REF.

2026 Revision

DRAWING No.

T5062

REV.